


GENERAL NOTES

- THESE DOCUMENTS ARE THE PROPERTY OF THE DESIGNER AND SHALL NOT BE COPIED, DUPLICATED, ALTERED, MODIFIED OR REVISED IN ANY WAY WITHOUT THE EXPRESSED WRITTEN APPROVAL OF THE DESIGNER.
- CONTRACTOR SHALL VERIFY ALL CONDITIONS AND DIMENSIONS AT THE SITE AND ALL INCONSISTENCIES SHALL BE BROUGHT TO THE ATTENTION OF THE DEVELOPER AND THE DESIGNER BEFORE PROCEEDING WITH THE WORK.
- ANY ERRORS OR OMISSIONS FOUND IN THESE DRAWINGS SHALL BE BROUGHT TO DEVELOPERS AND DESIGNERS ATTENTION IMMEDIATELY.
- DO NOT SCALE DRAWINGS. WRITTEN DIMENSIONS TAKE PRECEDENCE OVER SCALED DIMENSIONS.
- ALL DIMENSIONS ARE TO FACE OF STUD OR TO FACE OF FRAMING UNLESS OTHERWISE NOTED.
- ALL TRUSS DRAWINGS TO BE REVIEWED AND APPROVED BY THE STRUCTURAL ENGINEER PRIOR TO ISSUANCE OF BUILDING PERMIT.
- ALL OR EQUAL SUBSTITUTIONS MUST BE SUBMITTED TO AND APPROVED BY CITY BUILDING OFFICIAL PRIOR TO INSTALLATION.
- ALL ELECTRICAL AND MECHANICAL EQUIPMENT AND METERS ARE SUBJECT TO RELOCATION DUE TO FIELD CONDITIONS, CONTRACTOR TO VERIFY.
- DAMP PROOFING - ONE GOAT CONTINUOUS ELECTROMETRIC WATERPROOFING FROM GRADE LEVEL TO BOTTOM OF FOUNDATION.
- SHOP DRAWING REVIEW AND DISTRIBUTION, ALONG WITH PRODUCT SUBMITTALS, REQUESTED IN THE CONSTRUCTION DOCUMENTS, SHALL BE THE SOLE RESPONSIBILITY OF THE GENERAL CONTRACTOR, UNLESS DIRECTED OTHERWISE UNDER A SEPARATE AGREEMENT.
- DEVIATIONS FROM THESE DOCUMENTS IN THE CONSTRUCTION PHASE SHALL BE REVIEWED BY THE DESIGNER AND THE OWNER PRIOR TO THE START OF WORK IN QUESTION. ANY DEVIATIONS FROM THESE DOCUMENTS WITHOUT PRIOR REVIEW, SHALL BE THE SOLE RESPONSIBILITY OF THE GENERAL CONTRACTOR.
- THE GENERAL CONTRACTOR SHALL BE RESPONSIBLE FOR ALL WORK AND MATERIALS REPRESENTED ON THESE DOCUMENTS INCLUDING THE WORK AND MATERIALS FURNISHED BY SUBCONTRACTORS AND VENDORS.
- THE BUILDER SHALL FURNISH ART AND ALL REPORTS RECEIVED FROM THE GEOTECHNICAL ENGINEER (SOILS REPORT), ON THE STUDY OF THE PROPOSED SITE, TO THE DESIGNER, STRUCTURAL ENGINEER, AND GENERAL CONTRACTOR. IN THE EVENT THE GEOTECHNICAL REPORTS DO NOT EXIST, THE SOILS CONDITION SHALL BE ASSUMED TO BE A MINIMUM DESIGN SOIL PRESSURE STATED BY THE STRUCTURAL ENGINEER OF RECORD FOR THE PURPOSE OF STRUCTURAL DESIGN. GENERAL CONTRACTOR SHALL ASSURE THE SOIL CONDITIONS MEET OR EXCEED THE CRITERIA
- ALL WORK PERFORMED BY THE GENERAL CONTRACTOR SHALL COMPLY AND CONFORM WITH LOCAL AND STATE BUILDING CODES, ORDINANCES AND REGULATIONS, ALONG WITH ALL OTHER AUTHORITIES HAVING JURISDICTION. THE GENERAL CONTRACTOR IS RESPONSIBLE TO BE AWARE OF THESE REQUIREMENTS AND GOVERNING REGULATIONS.
- WINDOW SUPPLIER TO VERIFY AT LEAST ONE WINDOW IN ALL BEDROOMS TO HAVE A CLEAR EGRESS OPENING OF 5.7 SQ FT WITH MIN. DIMENSION OF 24" IN HEIGHT AND 20" IN WIDTH:

ABBREVIATIONS:

A.F.F. BD. BOT. B.R.L. BSMT C.I.F. C.J. CL. CMU COL. CONC. CONT. CW. DBL. DIA. DN DS DW DWG ELEC ELEV. E.P. EQ. Equip. E.W. Ex. F.A. FDN. FIN. FIN. FL. FL, FLR. FT FTG FLASH G.A. GALV G.F.C.I.	Above Finish Floor Board Bottom Bldg Restriction Lin Basement Change in Finish Ceiling Center Line Conc. Masonry Unit Column Concrete Continuous Cold Water Double Diameter Down Downspout Dishwasher Drawing Electric, Electrical Elevation Electrical Panel Equal Equipment Each Way Existing Fire Alarm Foundation Finish Finish Floor Floor Foot or Feet Footing Flashing Gauge Galvanized Ground Fault Circuit Interrupter Gypsum Wall Board Hose Bibb Hardwood Flooring Height Head Height Horizontal Hot Water Heater Insulation Interior	MISC. M.L. MECH METL. N/A N.I.C. NO. or #Number N.O.M. N.T.S O.C. P.TD. P.T. RAD./R REF. REQ. R.O. S.I.M. SPEC SF S.S. STD. STL. STOR. T.O.P. TYP. U.O.N.	Miscellaneous Microlam Mechanical Metal Not Applicable Not In Contract Nominal Not To Scale On Center Paint, Painted Pressure Treated Radius Refrigerator Required Rough Opening Similar Specification Square Feet Stainless Steel Standard Steel Storage Top of Plate Typical Unless Noted Otherwise Vertical Walk-In Closet Water Closet With Wood
--	---	--	--



LOCATION MAP:

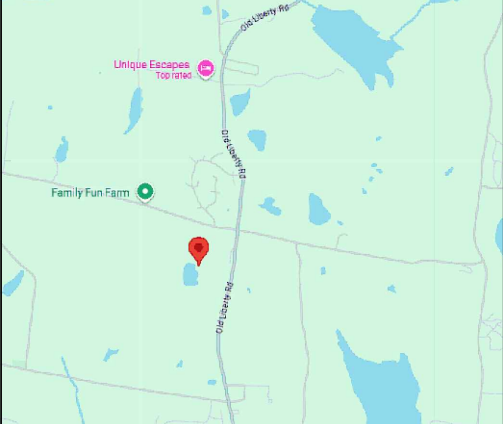

SHEET SCHEDULE:

SHEET NUMBER	SHEET NAME	SHEET ISSUE DATE
A - 1	GENERAL NOTES ABBREVIATIONS SITE MAP LOCATION MAP SHEET SCHEDULE	19-03-2025
A - 2	PROPOSED FIRST FLOOR PLAN	19-03-2025
A - 3	PROPOSED FRONT ELEVATION PROPOSED RIGHT - SIDE ELEVATION	19-03-2025
A - 4	PROPOSED LEFT - SIDE ELEVATION REAR ELEVATION	19-03-2025
A - 5	PROPOSED BUILDING SECTION PROPOSED 1 HR DIMISING BUILDING SECTION	19-03-2025
E - 1	PROPOSED ELECTRICAL PLAN ELECTRICAL EQUIPMENT LEGEND ELECTRICAL NOTES	19-03-2025
P - 1	PLUMBING DETAILS	19-03-2025
S - 1	STRUCTURAL NOTES	19-03-2025
S - 2	SCOPE OF WORK GIRDER REINFORCEMENT DETAIL DECK CONSTRUCTION DETAILS FLOOR JOIST SISTERING DETAILS TYPICAL REPLACEMENT FOOTING DETAIL	19-03-2025

SITE MAP:

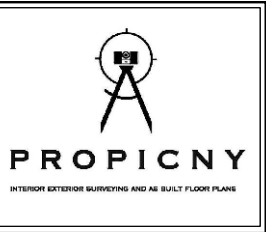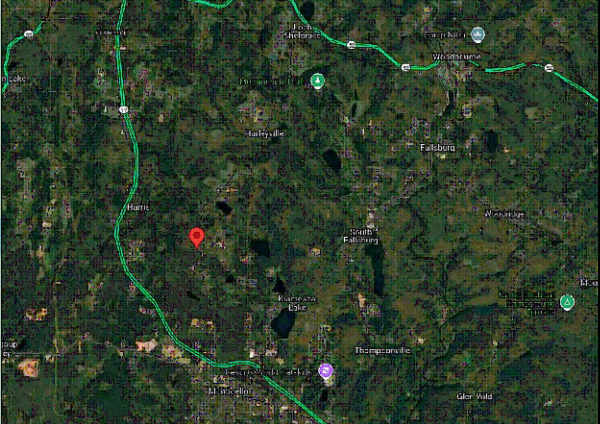

INTERIOR EXTERIOR
MAPPING AND SURVEYING
18 SPENCER BROOKLYN
NEW YORK 11211
(929) 486-9091
propicny.com
PROPICNY@GMAIL.COM

PROJECT NAME:
**ARCHITECTURAL AS-BUILT
UNIT 39 - 42
631 OLD LIBERTY ROAD
TOWN OF THOMPSON, NY**

ARCHITECT/ENGINEER

NO.	DATE	MARK / DESCRIPTION

SHEET CONTENT:
GENERAL NOTES
ABBREVIATIONS
SITE MAP
LOCATION MAP
SHEET NUMBER

DRAWN BY:	SHEET NO:
DATE:	A-1
CHECKED:	OF:
DATE:	05
PROJECT NO:	



PROPICNY

INTERIOR EXTERIOR SURVEYING AND AS-BUILT FLOOR PLANS

INTERIOR EXTERIOR
MAPPING AND SURVEYING
18 SPENCER BROOKLYN
NEW YORK 11211
(929) 486-9091
propicny.com
PROPICNY@GMAIL.COM


PROJECT NAME:
**ARCHITECTURAL AS-BUILT
UNIT 39 - 42
631 OLD LIBERTY ROAD
TOWN OF THOMPSON, NY**

ARCHITECT/ENGINEER

REVISIONS:		
NO.	DATE	MARK / DESCRIPTION

SHEET CONTENT:
PROPOSED FIRST FLOOR PLAN

DRAWN BY:	SHEET NO.:
DATE:	A-2
CHECKED:	OF:
DATE:	
PROJECT NO.:	05

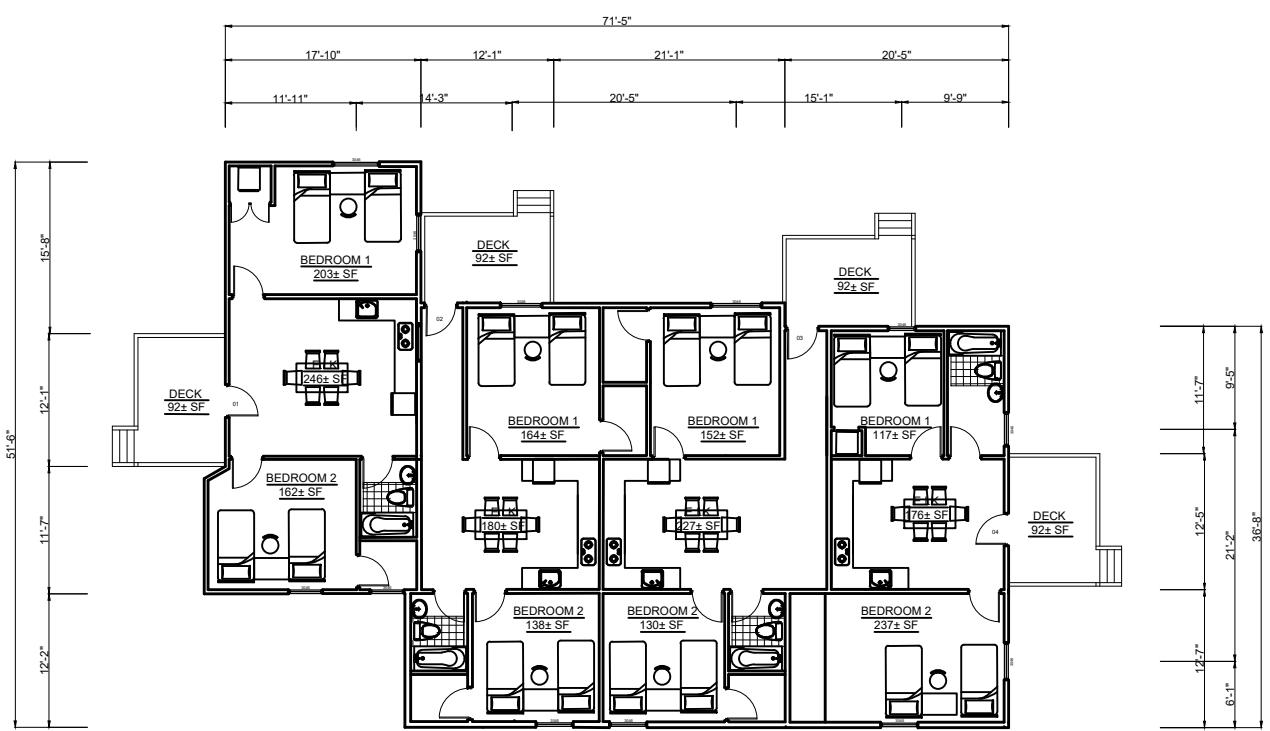

1 EXISTING FIRST FLOOR PLAN
SCALE: 1/4"=1'



PROPICNY

INTERIOR EXTERIOR SURVEYING AND AS-BUILT FLOOR PLANS

INTERIOR EXTERIOR
MAPPING AND SURVEYING
18 SPENCER BROOKLYN
NEW YORK 11211
(929) 486-9091
propicny.com
PROPICNY@GMAIL.COM


PROJECT NAME:
**ARCHITECTURAL AS-BUILT
UNIT 39-42
631 OLD LIBERTY ROAD
TOWN OF THOMPSON, NY**

ARCHITECT/ENGINEER


REVISIONS:		
NO.	DATE	MARK / DESCRIPTION

SHEET CONTENT:
EXISTING FRONT ELEVATION
EXISTING RIGHT - SIDE ELEVATION

DRAWN BY:	SHEET NO:
DATE:	A-3
CHECKED:	OF:
DATE:	
PROJECT NO:	05

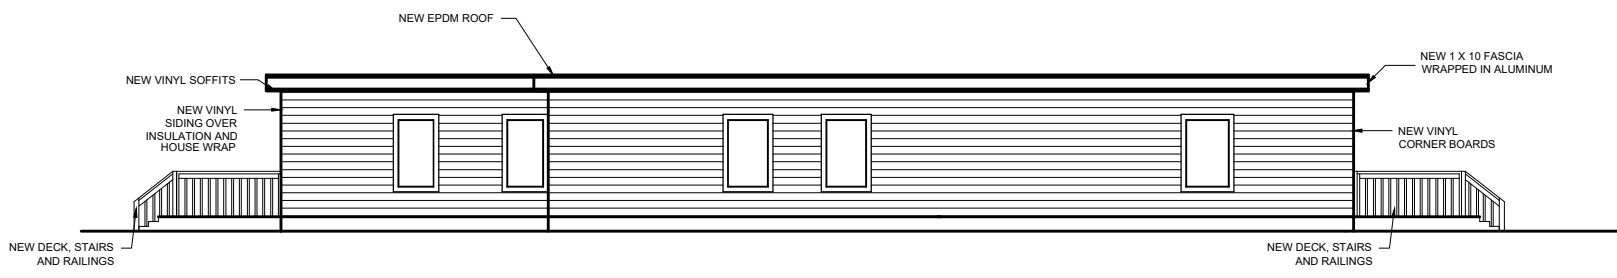

1 EXISTING FRONT ELEVATION
SCALE: 1/4"=1'

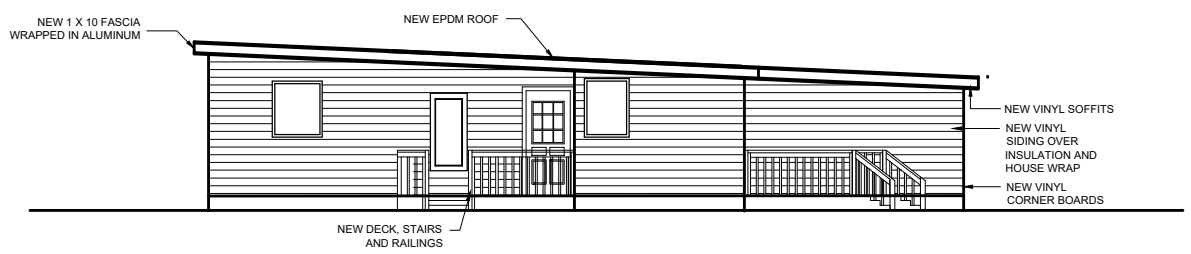

2 EXISTING RIGHT - SIDE ELEVATION
SCALE: 1/4"=1'



PROPICNY

INTERIOR EXTERIOR SURVEYING AND AS-BUILT FLOOR PLANS

INTERIOR EXTERIOR
MAPPING AND SURVEYING
18 SPENCER BROOKLYN
NEW YORK 11211
(929) 486-9091
propicny.com
PROPICNY@GMAIL.COM

PROJECT NAME:
**ARCHITECTURAL AS-BUILT
UNIT 39 - 42
631 OLD LIBERTY ROAD
TOWN OF THOMPSON, NY**

ARCHITECT/ENGINEER

MARK / DESCRIPTION


BUILDING SECTION
EXISTING 1 HR DIMISING BUILDING SECTION

SHEET NO.:


A-5

OF:


05

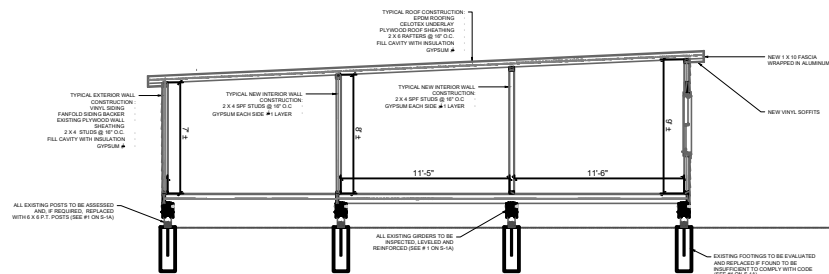

1 BUILDING SECTION
SCALE: 1/4"=1'

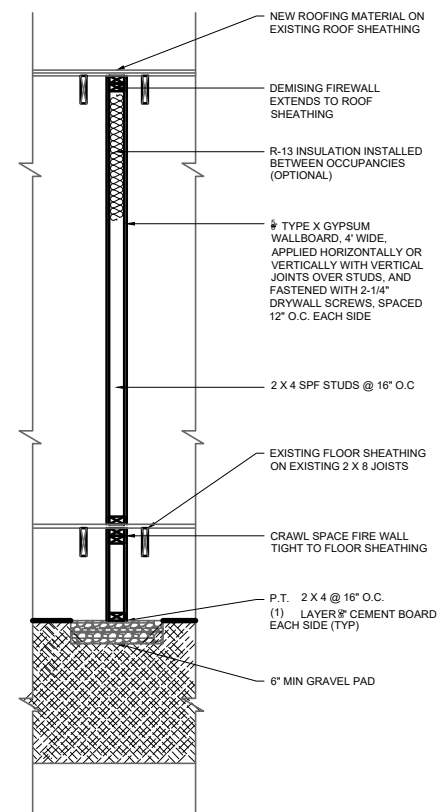

2 1 HR DIMISING BUILDING SECTION
SCALE: NTS

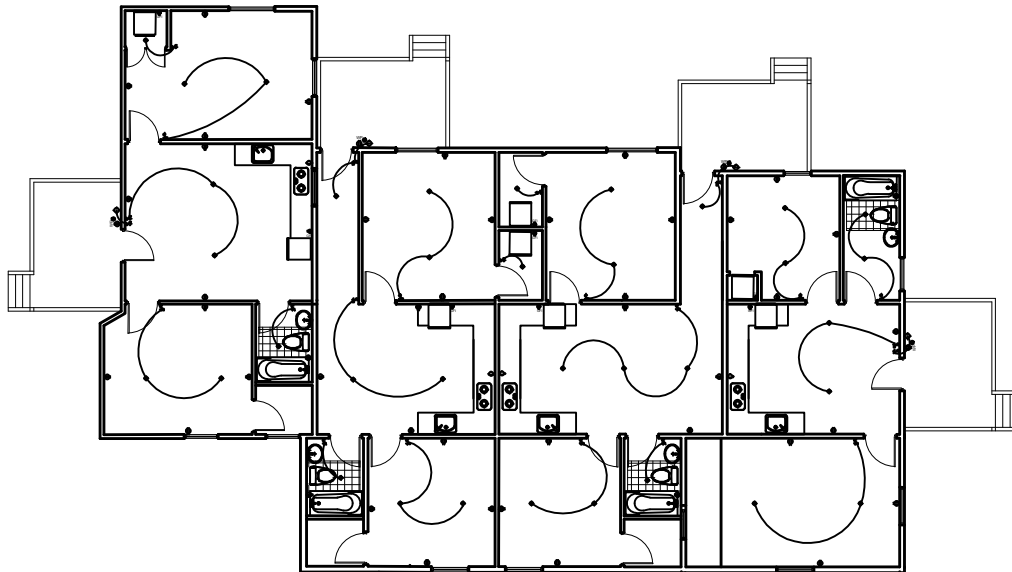

1
E-1
ELECTRICAL PLAN
SCALE: 3/16"=1'

NOTE:
ELECTRICAL PLANS INDICATE
THE MINIMUM REQUIREMENTS.
AS-BUILT CONDITIONS MAY VARY.

NOTE:
ALL SMOKE DETECTORS SHALL BE HARD WIRED FOR
SIMULTANEOUS OPERATION WITH 120V BATTERY BACK UP.

ELECTRICAL EQUIPMENT LEGEND	
SYMBOL	
	SINGLE POLE TOGGLE SWITCH
	TWO WAY TOGGLE SWITCH
	THREE WAY TOGGLE SWITCH
	CEILING MOUNTED LIGHT FIXTURE
	CEILING MOUNTED LIGHT & EXHAUST FAN COMB. FIXTURE
	RECESSED LIGHT FIXTURE
	CEILING FAN & LIGHT COMBINATION
	HARD WIRED 120V COMBINATION CARBON MONOXIDE-SMOKE DETECTOR CAPABLE OF SIMULTANEOUS ALARM WITH OTHER DETECTORS ON THEIR CIRCUIT
	HARD WIRED 120V SMOKE DETECTOR ONLY, CAPABLE OF SIMULTANEOUS ALARM WITH OTHER DETECTORS ON THEIR CIRCUIT
	WALL MOUNTED LIGHT FIXTURE
	DUPLEX RECEPTACLE, 120V
	20 AMPERE DUPLEX RECEPTACLE, GROUND FAULT INTERRUPTOR TYPE.
	30 AMPERE, 4 WIRE DRYER RECEPTACLE, 240V
	30 AMPERE, 4 WIRE RANGE RECEPTACLE, 240V
	DEDICATED OUTLET
	SPECIAL PURPOSE HARD WIRED ELECTRICAL CONNECTION
	WEATHERPROOF RECEPTACLE
	100A POWER PANEL, 40 POLE, 120/240V, NEMA 1
	2 SMALL APPLANCE CIRCUIT GFI
	OUTLETS IN BEDROOMS ARE ON ARC FAULT CIRCUITS
	GARAGE RECEPTACLE AND WP RECEPTACLE ON GFI CIRCUIT
	EVERYTHING IN BATHROOMS ARE ON GFI CIRCUIT
	BATH FAN, NO LIGHT

ELECTRICAL NOTES

- CONTRACTOR SHALL PROVIDE ALL LABOR, MATERIALS, INSURANCE, EQUIPMENT, INSTALLATION, CONSTRUCTION TOOLS, TRANSPORTATION, ETC. FOR A COMPLETE AND PROPERLY OPERATIVE SYSTEM ENERGIZED THROUGHOUT AND AS INDICATED ON DRAWINGS, AS SPECIFIED HEREIN AND/OR AS OTHERWISE REQUIRED.
- ALL MATERIALS AND EQUIPMENT SHALL BE NEW AND IN PERFECT CONDITION WHEN INSTALLED AND OF THE SAME MANUFACTURER THROUGHOUT FOR EACH CLASS OR GROUP OF EQUIPMENT. MATERIALS SHALL BE LISTED AND APPROVED BY UNDERWRITERS LABORATORIES (U.L.) AND SHALL BEAR THE INSPECTION LABEL "F" WHERE SUBJECT TO SUCH APPROVAL. MATERIALS SHALL MEET WITH APPROVAL OF ALL GOVERNING BODIES HAVING JURISDICTION AND SHALL BE MANUFACTURED IN ACCORDANCE WITH APPLICABLE STANDARDS ESTABLISHED BY ANSI, NEMA AND NBFU.
- ALL CIRCUIT BREAKERS, FUSES AND ELECTRICAL EQUIPMENT SHALL HAVE AN INTERRUPTING RATING NOT LESS THAN THE MAXIMUM SHORT CIRCUIT CURRENT TO WHICH THEY MAY BE SUBJECTED, AND A MINIMUM OF 10,000 A.I.C.
- METER SOCKETS AMPERES, VOLTAGE AND NUMBER OF PHASES SHALL BE NOTED AND SHALL BE MANUFACTURED BY SQUARE "D" COMPANY, SANGAMO OR APPROVED EQUAL. METER SOCKET SHALL BE APPROVED BY UTILITY COMPANY PRIOR TO INSTALLATION.
- WIRE AND CABLE CONDUCTORS SHALL BE COPPER WITH TYPE THIN INSULATION UNLESS SPECIFICALLY NOTED OTHERWISE.
- SERVICE CONDUCTORS MAY BE COPPER OR ALUMINUM.
- EACH CONDUCTOR OF EVERY SYSTEM SHALL BE PERMANENTLY TAGGED IN EACH PANEL BOARD.
- THE ENTIRE ELECTRICAL INSTALLATION SHALL BE GROUNDED AS REQUIRED BY ALL APPLICABLE CODES.



INTERIOR EXTERIOR
MAPPING AND SURVEYING
18 SPENCER BROOKLYN
NEW YORK 11211
(929) 486-9091
propicny.com
PROPICNY@GMAIL.COM

PROJECT NAME:
**ARCHITECTURAL AS-BUILT
UNIT 39 - 42
631 OLD LIBERTY ROAD
TOWN OF THOMPSON, NY**

ARCHITECT/ENGINEER

REVISIONS:	
DATE	MARK / DESCRIPTION

SHEET CONTENT:
ELECTRICAL PLAN
ELECTRICAL EQUIPMENT LEGEND
ELECTRICAL NOTES

DRAWN BY:	SHEET NO.:
DATE:	E-1
CHECKED:	OF:
DATE:	PROJECT NO.:

INTERIOR EXTERIOR
MAPPING AND SURVEYING
18 SPENCER BROOKLYN
NEW YORK 11211
(929) 486-9091
propicny.com
PROPICNY@GMAIL.COM

PROJECT NAME:
**ARCHITECTURAL AS-BUILT
UNIT 39 - 42
631 OLD LIBERTY ROAD
TOWN OF THOMPSON, NY**

ARCHITECT/ENGINEER

REVISIONS:



NO.	DATE	MARK / DESCRIPTION

SHEET CONTENT:

PLUMBING DETAILS



DRAWN BY:	SHEET NO.:
DATE:	P-1
CHECKED:	
DATE:	OF:
PROJECT NO.:	01

1/4" SCALE

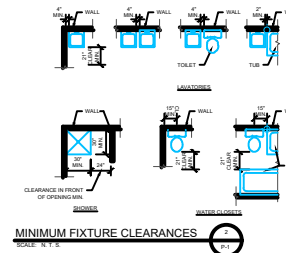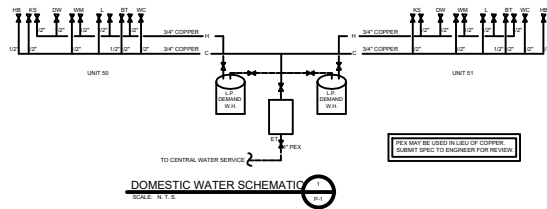



PLUMBING NOTES

1. THE ENTIRE PLUMBING INSTALLATION SHALL BE IN ACCORDANCE WITH THE APPLICABLE PROVISIONS OF THE IBC-RESIDENTIAL CODE.
2. WATER SERVICE ENTRANCE AND SANITARY EXT SHALL OCCUR WITHIN THE SAME AREA ON THE LOWER LEVEL. REFER TO SITE PLAN OR SURVEY FOR LOCATION OF SANITARY DISPOSAL SYSTEM AND WELL.
3. WELL AND SANITARY DISPOSAL SYSTEM SHALL BE DESIGNED BY A LICENSED PROFESSIONAL AND SHALL BE DESCRIBED IN ACCORDANCE WITH THE BUILDING CODE AND OTHER APPLICABLE REGULATIONS.
4. PIPE SUPPORT:
PEX: 2" HORIZONTAL AND 4" VERTICAL.
PVC: 4" HORIZONTAL AND 10" VERTICAL.
COPPER: 4" HORIZONTAL AND 10" VERTICAL.
5. ALL PLASTIC PIPE MATERIALS FOR SUPPLY OR WASTE SHALL BE IDENTIFIED AND LISTED IN ACCORDANCE WITH THE APPROPRIATE THIRD PARTY CERTIFICATIONS.
6. ONLY MANUFACTURED AND CODE COMPLIANT FIXTURES MAY BE USED.
7. WATER HEATER SHALL BE INSTALLED IN THE BATHROOM ADJACENT TO THE WATER SERVICE ENTRANCE. SIZE IN ACCORDANCE WITH THE DOMESTIC WATER SCHEMATIC.
8. WATER SUPPLY AND DISTRIBUTION SHALL BE INSTALLED IN ACCORDANCE WITH THE DOMESTIC WATER SCHEMATIC. INSTALLATION SHALL FOLLOW THE MANUFACTURER'S SPECIFICATIONS FOR PEX TUBING AND THE APPLICABLE PROVISIONS OF THE IBC RESIDENTIAL CODE.
9. DRAIN, WASTE AND VENT PIPE (DWV) SHALL BE SIZED IN ACCORDANCE WITH THE SANITARY RISER DIAGRAM.

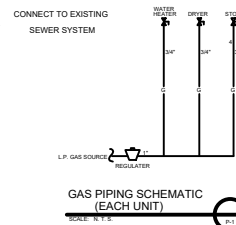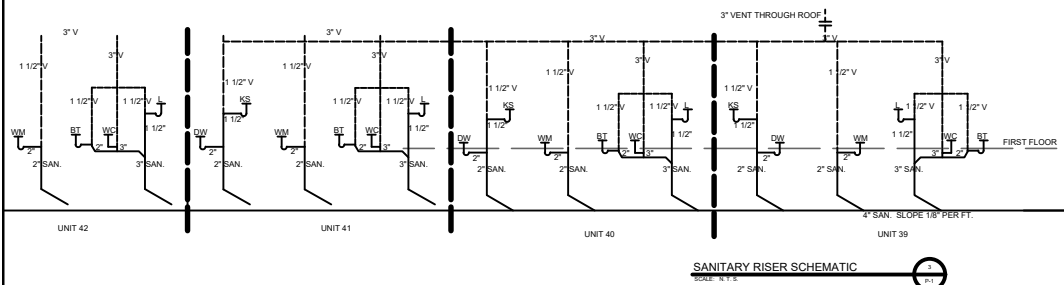

PLUMBING LEGEND

SYMBOL	DESCRIPTION
KS	RESIDENTIAL GRADE KITCHEN SINK W/ FAUCET
BT	RESIDENTIAL GRADE BATH TUB W/ FAUCET & SHOWER VALVE DIVERTER. INSTAL. SHOWER HEAD 8'-0" ABOVE FLOOR
WC	RESIDENTIAL GRADE WATER CLOSET W/ WATER SAVING FLUSHMETER (VALVE ADJUSTED)
L	BATHROOM LAVATORY W/ FAUCET
JT	RESIDENTIAL GRADE JACUZZI TUB
SH	RESIDENTIAL STAND-ALONE SHOWER
WH	10 GALLON PROPANE FIRED WATER HEATER
— 1/2" —	SANITARY SEWER WASTE PIPE, TYPE DWV ABS
— 3" —	SANITARY SEWER VENT PIPE, TYPE DWV ABS
— 1/2" —	DOMESTIC COLD WATER SUPPLY PIPE, PEX OR COPPER
— 1/2" —	DOMESTIC HOT WATER SUPPLY PIPE, PEX OR COPPER
— 1/2" —	GAS SUPPLY PIPE
— 1/2" —	SANITARY SEWER CLEAN OUT
— 1/2" —	DOMESTIC WATER SHUT-OFF VALVE
— 1/2" —	JOB SHUT-OFF BALL VALVE
WM	WASHING MACHINE
FP	SHOWER VENT CLEARANCE, FIREPLACE, 27.000 BTU/H INPUT (MAX.)
ET	EXPANSION TANK (AUTO PIS. SETTING)
F	FURNACE

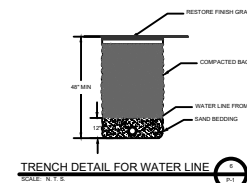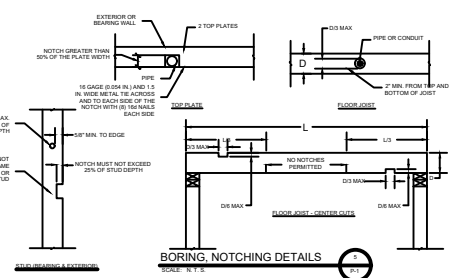

GENERAL NOTES

- ALL WORK SHALL CONFORM TO THE REQUIREMENTS OF THE 2020 NEW YORK STATE BUILDING CODE WITH AMENDMENTS, THE 2020 NEW YORK STATE ENERGY CONSERVATION CODE WITH AMENDMENTS, AND ALL OTHER APPLICABLE CODES & ORDINANCES.
- CONTRACTOR SHALL VISIT THE JOB SITE AND SHALL FAMILIARIZE HIMSELF WITH ALL CONDITIONS AFFECTING THE PROPOSED WORK AND SHALL MAKE PROVISIONS AS TO THE COST THEREOF. CONTRACTOR SHALL BE RESPONSIBLE FOR FAMILIARIZING HIMSELF WITH ALL CONTRACT DOCUMENTS, FIELD CONDITIONS AND DIMENSIONS AND CONFIRMING THAT THE WORK MAY BE ACCOMPLISHED AS SHOWN PRIOR TO PROCEEDING WITH CONSTRUCTION. ANY DISCREPANCIES SHALL BE BROUGHT TO THE ATTENTION OF THE ENGINEER AND OWNER PRIOR TO THE COMMENCEMENT OF WORK.
- PLANS ARE TO BE SCALED. THESE PLANS ARE INTENDED TO BE A DIAGRAMMATIC OUTLINE ONLY UNLESS OTHERWISE NOTED. THE WORK SHALL INCLUDE FURNISHING MATERIALS, EQUIPMENT AND APPURTENANCES AND LABOR NECESSARY TO EFFECT ALL INSTALLATIONS AS INDICATED ON THE DRAWINGS.
- DRAWINGS ARE INTENDED TO SHOW END RESULT OF DESIGN. MINOR MODIFICATIONS MAY BE REQUIRED TO SUIT JOB DIMENSIONS OR CONDITIONS, AND SUCH MODIFICATIONS SHALL BE INCLUDED AS PART OF THE WORK.
- CONTRACTOR SHALL RECEIVE CLARIFICATION IN WRITING, AND SHALL RECEIVE IN WRITING AUTHORIZATION TO PROCEED BEFORE STARTING WORK ON ANY ITEMS NOT CLEARLY DEFINED OR IDENTIFIED BY THE CONTRACT DOCUMENTS.
- CONTRACTOR SHALL SUPERVISE AND DIRECT THE WORK USING THE BEST CONSTRUCTION SKILLS AND ATTENTION. CONTRACTOR SHALL BE SOLELY RESPONSIBLE FOR CONSTRUCTION MEANS, METHODS, TECHNIQUES, SEQUENCES AND PROCEDURES AND FOR COORDINATING ALL PORTIONS OF THE WORK UNDER CONTRACT, UNLESS OTHERWISE NOTED.
- CONTRACTOR SHALL SECURE ALL NECESSARY BUILDING PERMITS AND INSPECTIONS AND PAY ALL REQUIRED FEES.
- CONTRACTOR SHALL MAINTAIN LIABILITY INSURANCE TO PROTECT THE OWNER.

DESIGN CRITERIA

DESIGN CRITERIA (OTHER THAN TABLE R403.2(1))

- SOIL BEARING CAPACITY	2000 PSF MIN
- SLOPES ASSUMED LESS THAN 8%	FOOTINGS ASSUMED NOT ADJACENT TO SLOPES
- WIND EXPOSURE CATEGORY	C
- ROOF LIVE LOAD	SNOW ZONE 50
- ROOF LIVE LOAD (301.6)	16 PSF
- ROOF DEAD LOAD	10 PSF
- FLOOR LIVE LOAD	40 PSF
- FLOOR DEAD LOAD	10 PSF
- SLEEPING ROOM LIVE LOAD	30 PSF
- SLEEPING ROOM DEAD LOAD	10 PSF
- ATTIC WITH STORAGE	20 PSF
- EXTERIOR DECK	40 PSF
- STAIRS	40 PSF

ENERGY CODE CRITERIA

- ENERGY CODE CRITERIA
- RESHECK CALCULATION AND COMPLIANCE CERTIFICATE ATTACHED WITH THESE DRAWINGS. DESIGN ASSUMES GASHEAT AND BASEMENT ARE UNHEATED. RAISED RAFTER HEEL DOES NOT APPLY.
 - ZONE 5 (SULLIVAN COUNTY)
 - HEATING DEGREE DAYS 5750
 - WINTER DESIGN TEMPERATURE 8 F
 - SUMMER DRY BULB 83 F
 - SUMMER WET BULB 73 F
 - GLAZING U FACTOR 0.32
 - MAXIMUM GLAZING 15 % (GROSS AREA)
- AS A LEVEL 1 ALTERATION, THIS PROJECT WILL COMPLY WITH NY 1109.1.1 (R503.1.1) BUILDING ENVELOPE, EXCEPTION 2.

EXISTING CEILING, WALL OR FLOOR CAVITIES EXPOSED DURING CONSTRUCTION SHALL NOT BE REQUIRED TO COMPLY THESE CAVITIES TO BE FILLED WITH R-39 INSULATION TO CAPACITY.

AIR LEAKAGE
THE BUILDING THERMAL ENVELOPE SHALL BE CONSTRUCTED TO LIMIT AIR LEAKAGE IN ACCORDANCE WITH THE REQUIREMENTS OF SECTIONS R402.4.1 THROUGH R402.4.4 OF THE 2015 IECC.

DUCTS
DUCTS AND AIR HANDLERS SHALL BE IN ACCORDANCE WITH SECTIONS R403.3.1 THROUGH R403.3.5 OF THE 2015 IECC.

SITE WORK NOTES

- ALL EXCAVATIONS SHALL BE DETERMINED BY STUMPING, PUMPING, ETC. IN A MANNER WHICH WILL NOT LOOSEN FOUNDATION SURGRADE MATERIAL. SURFACE WATER SHALL BE DIVERTED AWAY FROM EXCAVATIONS BY MEANS OF BERMS, DIVERSION DITCHES, OR OTHER SUITABLE METHODS.
- CONFINED EXCAVATIONS FOR FOUNDATIONS, UTILITIES, ETC. SHALL BE LIMITED TO 4 FEET IN DEPTH UNLESS SHORING AND BRACING IS USED. TRENCH EXCAVATIONS DEEPER AND/OR BRACING SHALL CONFORM WITH THE LATEST OSHA REGULATIONS.
- BACKFILL SHALL BE PLACED IN MAXIMUM LOOSE LEFT THICKNESSES OF 8 INCHES AND COMPACTED WITH SUITABLE COMPACTION EQUIPMENT. ALL FILL SHALL BE COMPACTED TO AT LEAST 95% OF MAXIMUM DRY DENSITY PER ASTM D1557. IN CONFINED AREAS WHERE ONLY HAND TAMPING IS FEASIBLE, FILL SHALL BE PLACED IN MAXIMUM 4 INCH LOOSE LEFTS AND COMPACTED TO THE ABOVE MENTIONED CRITERIA.
- ALL FILL SHALL BE CLEAN AND FREE OF LARGE ROCK, NO ORGANIC MATTER SHALL BE PERMITTED.
- TEMPORARY EROSION CONTROL STRUCTURES SHALL BE INSTALLED AS REQUIRED AFTER THE SITE IS DISTURBED.

CONCRETE NOTES

- DESIGN AND CONSTRUCTION SHALL CONFORM TO THE AMERICAN CONCRETE INSTITUTE BUILDING CODE REQUIREMENTS FOR REINFORCED CONCRETE ACI 318, LATEST EDITION.
- CONCRETE WORK AND MATERIALS SHALL CONFORM TO THE AMERICAN CONCRETE INSTITUTE "SPECIFICATIONS FOR STRUCTURAL CONCRETE FOR BUILDINGS," ACI 308.
- REINFORCING STEEL SHALL BE DEFORMED BARS CONFORMING TO ASTM A615, GRADE 60. "DEFORMED AND PLAN BILLET STEEL BARS FOR CONCRETE REINFORCEMENT".
- WELDED WIRE FABRIC SHALL CONFORM TO ASTM A188, "WELDED STEEL WIRE FABRIC FOR CONCRETE REINFORCEMENT".
- CONCRETE SLUMP SHALL NOT EXCEED 5 INCHES UNLESS SPECIFICALLY AUTHORIZED BY THE ENGINEER. SLUMP SHALL BE DETERMINED IN ACCORDANCE WITH ASTM C143.
- READY MIX CONCRETE SHALL COMPLY WITH ACI 308.4 AND ASTM C-34 WITH A MAXIMUM WATER CEMENT RATIO OF 0.50. TIME BETWEEN INTRODUCTION OF WATER AND THE PLACEMENT OF CONCRETE SHALL NOT EXCEED 1.5 HOURS.
- PROVIDE AIR ENTRAINMENT IN EXTERIOR EXPOSED CONCRETE TO OBTAIN TOTAL AIR CONTENT OF 5% ± 1% IN ACCORDANCE WITH ACI 308.
- CONCRETE COVER FOR REINFORCEMENT SHALL BE 3 INCHES FOR CONCRETE CAST AGAINST AND PERMANENTLY EXPOSED TO EARTH. AT ALL OTHER CONCRETE SURFACES, MINIMUM COVER SHALL BE 2 INCHES FOR #6 AND LARGER BARS, AND 1 1/2 INCHES FOR #5 AND SMALLER BARS.
- ALL REINFORCING SHALL BE CONTINUOUS AND SHALL BE LAPPED 40 BAR DIAMETERS AT SPICES, BEST AROUND CORNERS, AND HOOKED AT NON-CONTINUOUS ENDS.
- EXTERIOR WALKING SURFACES SHALL RECEIVE A BROOM FINISH.
- DRYING OUT OF CONCRETE, ESPECIALLY DURING THE FIRST 24 HOURS, SHALL BE CAREFULLY GUARDED AGAINST. ALL SURFACES SHALL BE MOIST CURED OR PROTECTED USING A MEMBRANE CURING AGENT APPLIED AS SOON AS FORMS ARE REMOVED. IF MEMBRANE CURING AGENT IS USED, EXERCISE CARE NOT TO DAMAGE SURFACE.

CONCRETE REQUIREMENTS

UNIT WT	150 PCF (NORMAL WEIGHT)
COMPRESSIVE STRENGTH	3500 PSI @ 28 DAYS
CEMENT	TYPE I, ASTM C-150
COURSE AGGREGATE	3/8" MAX. ASTM C-33
SLUMP	5 ± 1, ASTM C-143
WATER CEMENT RATIO	LESS THAN OR EQUAL TO 0.50
CURING	LIQUID MEMBRANE (ASTM C-309, TYPE II, CLASS A)
FINISH	STEEL TROWEL

NOTE:
UNLESS OTHERWISE NOTED, ALL DIMENSIONS ARE FROM ROUGH MATERIAL TO ROUGH MATERIAL AND ARE APPROXIMATE. MINOR MODIFICATIONS MAY BE NECESSARY AND ARE INCLUDED AS PART OF THIS WORK.

MASONRY NOTES

- DESIGN AND CONSTRUCTION OF ALL MASONRY WORK SHALL CONFORM TO ACI 530 AND 530.1 STANDARDS BUILDING CODE REQUIREMENTS FOR MASONRY STRUCTURES," AND "SPECIFICATIONS FOR MASONRY STRUCTURES."
- CONCRETE MASONRY UNITS SHALL BE NORMAL WEIGHT HOLLOW LOAD BEARING UNITS CONFORMING TO ASTM C90 TYPICAL LOAD BEARING CONCRETE MASONRY UNITS," LATEST EDITION. COMPRESSIVE STRENGTH OF MASONRY SHALL NOT BE LESS THAN 2000 PSI. COLOR AND FINISH AS INDICATED, SUBJECT TO APPROVAL BY OWNER.
- MORTAR SHALL CONFORM TO ASTM C270 "MORTAR FOR UNIT MASONRY," TYPE M OR S.
- GROUT SHALL CONFORM TO ASTM C476 "GROUT FOR REINFORCED AND NONREINFORCED MASONRY." ALL CELLS SHALL BE FILLED SOLID WITH GROUT AT REINFORCING.
- ALL MASONRY SHALL BE CONSTRUCTED IN RUNNING BOND. MATTER SHALL BE PERMITTED.
- HORIZONTAL JOINT REINFORCING SHALL BE STANDARD WEIGHT LADDER TYPE (NO. 3 GAGE SIDE RODS) SPACED VERTICALLY AS INDICATED, DUR-O-WALL OR EQUAL.

WOOD NOTES

- FRAMING LAMBER SHALL BE AS FOLLOWS: (U.O.N.)
A. JOISTS, RAFTERS, GIRDERS & HEADERS: DOUGLAS FIR OR SPRUCE-PINE-FIR, NO. 2 OR BETTER.
B. STUDS, MINIMUM NO. 3 STANDARD OR STUD GRADE LAMBER.
C. PLYWOOD, U.O.N. (UNLESS ZIP SYSTEM IS USED): SUB-FLOOR - 3/4" T&G ACQ PLYWOOD STRUCTURAL GRADE, GLUED AND NAILED. WALLS - 1/2" OSB STRUCTURAL GRADE EXTERIOR ROOF - 1/2" CDX PLYWOOD STRUCTURAL GRADE EXTERIOR.
D. IN CONTACT WITH THE GROUND, OR EXPOSURE TO WEATHER, SOUTHERN PINE PRESSURE TREATED (ACQ).

- ALL STRUCTURAL MEMBERS SHALL BE FASTENED IN ACCORDANCE WITH THE REQUIREMENTS OF TABLE R602.3(1).
- FIREBLOCKING SHALL BE PROVIDED IN THE FOLLOWING LOCATIONS:

- A. IN CONCEALED SPACES OF STUD WALLS AND PARTITIONS, INCLUDING FURRED SPACES UNDER FLOOR JOISTS AND FLOOR LEVELS. CONCEALED HORIZONTAL FURRED SPACES SHALL ALSO BE FIREBLOCKED AT INTERVALS NOT EXCEEDING 10 FEET.
- B. AT ALL INTERCONNECTIONS BETWEEN CONCEALED VERTICAL SPACES SUCH AS OCCUR AT SOFFITS, DROP CEILING, AND COVE CEILING.
- C. IN CONCEALED SPACES BETWEEN STAR STRINGERS AT THE TOP AND BOTTOM OF THE RUN.
- D. AT OPENINGS AROUND VENTS, PIPES AND DUCTS AT CEILING AND FLOOR LEVEL, TO RESIST THE FREE PASSAGE OF FLAME AND PRODUCTS OF COMBUSTION.
- E. FIREBLOCKING OF CHIMNEYS AND FIREPLACES SHALL BE IN ACCORDANCE WITH R101.16.

- RAFTERS AND CEILING JOISTS HAVING A DEPTH-TO-THICKNESS RATIO EXCEEDING 5 TO 1 BASED ON NOMINAL DIMENSIONS SHALL BE SUPPORTED LATERALLY BY SOLID BLOCKING. DIAGONAL BRIDGING (WOOD OR METAL) OR CONTINUOUS 1 INCH BY 3 INCH WOOD STRIP NAILLED ACROSS THE RAFTERS OR CEILING JOISTS AT INTERVALS NOT EXCEEDING 8 FEET.
- OPENINGS IN CEILING AND CEILING FRAMING SHALL BE FRAMED WITH HEADER AND TRIMMER JOISTS. WHEN THE HEADER JOIST SPAN DOES NOT EXCEED 4 FEET, THE HEADER JOIST MAY BE A SINGLE MEMBER THE SAME SIZE AS THE CEILING JOIST OR RAFTER. SINGLE TRIMMER JOISTS MAY BE USED TO CARRY A SINGLE HEADER JOIST THAT IS LOCATED WITHIN 3 FEET OF THE TRIMMER JOIST BEARING.
- ALL MICROLAM BEAMS, LIV. SHALL HAVE A MINIMUM F_b OF 2,800 PSI E=2.0.
- IF ROOF OR FLOOR TRUSSES ARE USED THEY MUST BE DESIGNED FOR THE MINIMUM LOADS IN THESE NOTES & AS REQUIRED BY CODE. SHOP DRAWINGS OF TRUSSES TO BE USED MUST BEAR THE SEAL OF A REGISTERED ARCHITECT OR ENGINEER.
- PROVIDE CROSSBRACING BETWEEN JOISTS @ 8' O.C. MAXIMUM.
- WOOD POSTS UNDER BEAMS SHALL BE AS WIDE AS THE BEAM IT CARRIES.
- IF WALL STUDS ARE OVER 10 FEET HIGH THAN CATS SHALL BE PROVIDED AT THESE POINTS.
- ALL METAL CONNECTORS SHALL BE SIMPSON STRONG-TIE OR APPROVED EQUAL.
- PROVIDE RAFTER TIES (H-Z, HURRICANE) AT EACH RAFTER END ON WALL TOP PLATES.

ROOFING NOTES

- ROOF SHINGLE, ROOF SHINGLES SHALL BE UL TYPE CLASS A FIBERGLASS OR ASPHALT STRIP SHINGLES, 205 MINIMUM. INSTALL PER MANUFACTURERS SPECIFICATIONS. PROVIDE UNDERLAYMENT AS SPECIFIED BELOW AND METAL Drip EDGE AT ALL ROOF EDGES.
- ROOF UNDERLAYMENT: FOR ROOF SLOPES FROM TWO UNITS VERTICAL IN 12 UNITS HORIZONTAL (17 PERCENT SLOPE), UP TO FOUR UNITS VERTICAL IN 12 UNITS HORIZONTAL (33 PERCENT SLOPE), UNDERLAYMENT SHALL BE TWO LAYERS APPLIED IN THE FOLLOWING MANNER: APPLY A 19 INCH STRIP OF UNDERLAYMENT FELT PARALLEL WITH AND STARTING AT THE EAVES, FASTENED SUFFICIENTLY TO HOLD IN PLACE. STARTING AT THE EAVE, APPLY 36 INCH WIDE SHEETS OF UNDERLAYMENT, OVERLAPPING SUCCESSIVE SHEETS 19 INCHES, AND FASTENED SUFFICIENTLY TO HOLD IN PLACE. FOR ROOF SLOPES OF FOUR UNITS VERTICAL IN 12 UNITS HORIZONTAL (33 PERCENT SLOPE) OR GREATER, UNDERLAYMENT SHALL BE ONE LAYER APPLIED IN THE FOLLOWING MANNER: UNDERLAYMENT SHALL BE APPLIED SINGLE FASHION, PARALLEL TO AND STARTING FROM THE LAVE AND LAPPED 2 INCHES, FASTENED SUFFICIENTLY TO HOLD IN PLACE. END LAPS SHALL BE OFFSET BY 4 FEET.
- ICE PROTECTION: AN ICE BARRIER THAT CONSISTS OF AT LEAST TWO LAYERS OF UNDERLAYMENT CEMENTED TOGETHER OR ELEV. ELEVATION ENGINEER.
- CRICKETS AND SADDLES: A CRICKET OR SADDLE SHALL BE INSTALLED ON THE RIDGE SIDE OF ANY CHIMNEY GREATER THAN 30 INCHES WIDE. CRICKET OR SADDLE COVERS SHALL BE SHEET METAL OR OF THE SAME MATERIAL AS THE ROOF COVERING.
- SIDEWALL FLASHING: FLASHING AGAINST A VERTICAL SIDEWALL SHALL BE BY THE STEEL-FLASHING METHOD.
- OTHER FLASHING: FLASHING AGAINST A VERTICAL FRONT WALL, AS WELL AS SOIL STACK, VENT PIPES AND CHIMNEY FLASHING, SHALL BE APPLIED ACCORDING TO ASPHALT SHINGLE MANUFACTURERS PRINTED INSTRUCTIONS.

FINISHES

- ALL GYPSUM BOARD TO BE OF TYPE AND THICKNESS SHOWN, TAPED, SPOCKLED 3 COATS, AND SANDED TO A SMOOTH FINISH.
 - WALLS & CEILINGS, U.O.N. 1/2"
 - GARAGE CEILING 5/8" TYPE "X" FIRE RATED
 - GARAGE WALLS 5/8" TYPE "X" FIRE RATED
 - UNDER STAIR PROTECTION 1/2"
 - BATHROOM WALLS 1/2" MOISTURE RESIST
- ALL GYPSUM BOARD SHALL BE SCREW APPLIED IN ACCORDANCE WITH MANUFACTURERS SPECIFICATIONS. CONTRACTOR HAS OPTION OF GLUING.
- FINISHED CEILING AND WALLS SHALL RECEIVE MIN TWO COATS OF PAINT WITH FIRST COAT PRIMER, UNLESS OTHERWISE NOTED.
- ALL PAINT USED SHALL BE INSTALLED IN ACCORDANCE WITH THE MANUFACTURERS SPECIFICATIONS FOR THAT PRODUCT.
- VINYL SIDING SHALL BE INSTALLED PER MANUFACTURERS SPECIFICATION. FASTENERS SHALL BE ALUMINUM OR STAINLESS STEEL COATED AND NAILED AT 16" OC.
- A BUILDING HOUSE WRAP SHALL BE USED UNDER VINYL SIDING. HOUSE WRAP SHALL LAP 2" ON HORIZONTAL JOINTS AND 2" ON VERTICAL JOINTS. INSTALL PER MANUFACTURERS SPECIFICATIONS.
- GUTTER AND DOWN SPOUTS SHALL BE INSTALLED WITH POSITIVE DRAINAGE AWAY FROM STRUCTURE.
- FINISHED GARAGE AND DRIVEWAY SHALL PITCH AWAY FROM THE STRUCTURE SO THAT SURFACE WATER FLOWS AWAY FROM STRUCTURE.

ABBREVIATIONS

A.B.	ANCHOR BOLT	HORIZ.	HORIZONTAL
A.F.F.	ABOVE FINISH FLOOR	INSUL.	INSULATION
ARCH.	ARCHITECT	INTERS.	INTERSECTIONS
A.S.L.	ABOVE SEA LEVEL	MAX.	MAXIMUM
BIT.	BITUMINOUS	M.D.O.	MEDIUM DENSITY OVERLAY
B.O.	BOTTOM OF	MIN.	MINIMUM
BRD.	BOARD	M.T.D.	MOUNTED
BTM.	BOTTOM	N.I.C.	NOT IN CONTRACT
CANT.	CANTILEVERED	O.C.	ON CENTER
C.L.G.	CEILING	OPNG.	OPENING
CL.	CENTERLINE	OPP.	OPPOSITE
COL.	COLUMN	PLYWD.	PLYWOOD
CONC.	CONCRETE	P.N.L.	PANEL
CONT.	CONTINUOUS	P.T.	PRESSURE TREATED
DA.	DIAMETER	P.TD.	PAINTED
DR.	DOOR	REQ.	REQUIRED
DRWG.	DRAWING	RM.	ROOM
D.S.	DOWN SPOUT	R.O.	ROUGH OPENING
EL.	ELEVATION	S.F.	SQUARE FEET
ELEC.	ELECTRICAL	SM.	SHIMLAR
ELEV.	ELEVATION	SQ.	SQUARE
ENG.	ENGINEER	S.S.	STAINLESS STEEL
EQ.	EQUAL	STD.	STANDARD
EXT.	EXTERIOR	STL.	STEEL
EXTS.	EXISTING	STRUC.	STRUCTURAL
OR EXIST.	OR EXISTING	SUBFL.	SUBFLOOR
F.	FRAMING	T&B	TOP AND BOTTOM
FN.	FINISH	T.B.D.	TO BE DECIDED
FL.	FLOOR	T.O.F.	TOP OF
F.M.-F.	FACE OF MASONRY TO FACE OF MASONRY	T.Y.P.	TYPICAL
F.O.	FACE OF	V.I.F.	VERIFY IN FIELD
FOUND.	FOUNDATION	VERT.	VERTICAL
F.R.	FIBER REINFORCED	V.S.T.	VERTICAL
GALV.	GALVANIZED	VB.	VERTICULE
G.C.	GENERAL CONTRACTOR	W.	WITH
G.W.B.	GYPSUM WALL BOARD	WIND.	WINDOW
		WD.	WOOD
		W.W.F.	WELDED WIRE FABRIC

WINDOWS & DOORS

- WINDOWS AND DOORS SHALL BE SIZE, TYPE AND MANUFACTURER AS INDICATED ON SCHEDULES. ALL WINDOWS AND DOORS SHALL BE MANUFACTURED TO MEET THE APPROPRIATE SECTIONS OF THE IRC AND LABELLED AS SUCH. LABELS SHALL REMAIN ON WINDOWS FOR INSPECTION UNTIL A CERTIFICATE OF OCCUPANCY IS GRANTED BY THE CODE ENFORCEMENT OFFICER.
- TEMPERED GLASS, AS INDICATED IN NOTE 3 AND ON THE DOOR AND WINDOW SCHEDULES, SHALL HAVE A MANUFACTURERS LABEL DESIGNATING THE TYPE AND THICKNESS OF THE GLASS AND THE SAFETY GLAZING STANDARD WITH WHICH IT COMPLIES.
- GLAZING LESS THAN 16" ABOVE FLOOR, GREATER THAN 9 SQUARE FEET IN AREA, INSTALLED IN DOORS, INSTALLED IN SIDLITES AND ADJACENT TO TUBSHOWERS SHALL BE TEMPERED, AS INDICATED ON THE SCHEDULES.
- EXTERIOR WINDOW, DOOR, AND VENT OPENINGS SHALL BE CALLED, FLASHED, WEATHERSTRIPPED OR OTHERWISE SEALED TO THE SIBWALL IT IS FASTENED TO.
- EGRESS WINDOWS SHALL BE INSTALLED AS INDICATED IN THE SCHEDULE. IF SUBSTITUTIONS ARE USED, CONTRACTOR MUST CONFIRM EGRESS MEETS THE MINIMUM 5.7 OF 56 SF AT GRADE. ADDITIONALLY, SILL HEIGHTS FOR EGRESS WINDOWS MAY NOT EXCEED 44" FROM FINISHED FLOOR AND MINIMUM NET CLEAR OPENING HEIGHT SHALL BE 24" AND THE MINIMUM NET CLEAR OPENING WIDTH SHALL BE 20".



INTERIOR EXTERIOR
MAPPING AND SURVEYING
18 SPENCER BROOKLYN
NEW YORK 11211
(929) 486-9091
propicny.com
PROPICNY@GMAIL.COM


ARCHITECTURAL AS-BUILT
UNIT 39 - 42
631 OLD LIBERTY ROAD
TOWN OF THOMPSON, NY

ARCHITECT/ENGINEER	
DATE	MARK / DESCRIPTION
SHEET CONTENT:	
STRUCTURAL NOTES	
SHEET NO.: S-1	
OF:	
PROJECT NO.:	02

GROUND SNOW LOAD	WIND SPEED (mph)	SEISMIC DESIGN CATEGORY	SUBJECT TO DAMAGE FROM				WINTER DESIGN TEMP.	ICE-SHIELD UNDERLAYMENT REQUIRED	FLOOD HAZARDS
			WEATHERING	FROST LINE DEPTH	TERMITES	DECAY			
50	115	C	SEVERE	48"	MODERATE TO HEAVY	SLIGHT TO MODERATE	6F	YES	CASE STUDY


SCOPE OF WORK

- 1) STABILIZATION
 - a) REMOVE TREES AND VEGETATION WITHIN 10' OF STRUCTURE
 - i) LEVEL OFF ROUGH GRADE WITHIN 10' OF STRUCTURE
 - b) COVER EXISTING ROOF WITH A WATERPROOF TARP
 - 2) DEMOLITION (ASBESTOS INSPECTION AND REMEDIATION MAY BE REQUIRED)
 - a) REMOVE AND DISPOSE OF:
 - i) EXTERIOR
 - (1) ALL SIDING AND HOUSE WRAP TO BUILDING SHEATHING
 - (2) ALL EXISTING WINDOWS AND EXTERIOR TRIM
 - (3) ALL EXISTING FOUNDATION "SKIRT" MATERIALS
 - (4) ALL EXISTING PORCHES AND DECKS
 - (5) ALL SOFFIT FASCIA AND EXTERIOR TRIM
 - (6) ALL EXISTING EXTERIOR DOORS
 - ii) ROOF (AFTER STABILIZATION OF FOUNDATION, FRAMING AND CONSTRUCTION OF EXTERIOR DECKS WITH ROOF SUPPORTS)
 - (1) ALL ROOFING MATERIALS TO ROOF SHEATHING
 - (2) ANY DETERIORATED ROOF SHEATHING OR RAFTERS
 - iii) INTERIOR
 - (1) ALL REMAINING APPLIANCES
 - (2) ALL REMAINING PLUMBING FIXTURES
 - (3) ALL CEILING FINISHES
 - (4) ALL INTERIOR TRIM AND DOORS
 - (5) ALL INTERIOR WALL FINISHES
 - (6) ALL INTERIOR FLOOR COVERINGS TO EXISTING BUILDING SUB-FLOOR
 - (7) ALL ELECTRICAL, PHONE OR CABLE INSTALLATIONS
 - (8) ANY NON-STRUCTURAL WALLS PER PROPOSED PLANS
 - (9) REMOVE SECTIONS OF SUB-FLOOR TO ALLOW INSPECTIONS OF FLOOR FRAMING AND FOUNDATION CONDITIONS BELOW.
- 3) PRE CONSTRUCTION INSPECTION
 - a) FOUNDATION AND FLOORS. FLOORS MUST BE LEVELED TO A DEVIATION OF NO MORE THAN 9/16 IN 20' (SEE DETAILS THIS PAGE)
 - (1) EVALUATE EXISTING FOOTINGS AND SUPPORT POSTS FOR INTEGRITY RECOMMEND REPLACEMENT OR REPAIR OF SUB-STANDARD FOOTINGS
 - (2) ALL SUPPORT POSTS TO BE ASSESSED AND REPLACED WITH PRESSURE TREATED 6 X 6 POSTS AND REQUIRED SIMPSON POST CAPS AND BASES PER CODE IF FOUND TO BE DEFICIENT.
 - ii) EVALUATE EXISTING GIRDERS
 - (1) ALL EXISTING GIRDERS FOUND TO BE COMPROMISED WITH ROT ARE TO BE REPLACED
 - (2) ALL EXISTING GIRDERS ARE TO BE REINFORCED PER CONSTRUCTION DRAWINGS (THIS PAGE)
 - iii) EVALUATE EXISTING FLOOR JOISTS
 - (1) FLOOR JOISTS TO BE INSPECTED FOR ROT OR OTHER DEFICIENCIES (EXCESSIVE DRILLING, NOTCHING OR CUTTING, INSECT OR VERMIN ACTIVITY)
 - (2) ANY DEFICIENT FLOOR JOISTS ARE TO BE NOTED AND REPLACED OR SISTERED.
 - iv) EVALUATE EXISTING SUB-FLOOR
 - (1) ALL COMPROMISED ELEMENTS ARE TO BE REPLACED
- 4) EXTERIOR DECKS (SEE 4 ON S-1A. ALL WORK TO CONFORM WITH R507)
 - a) ALL EXTERIOR DECKS AND PORCHES TO BE REBUILT WITH PRESSURE TREATED MATERIAL PER DRAWINGS
 - i) NEW FOOTINGS TO BE INSTALLED PER R507.3
 - ii) NEW LEDGER BOARDS TO BE PROPERLY FLASHED AND SECURED TO BUILDING PER R507.9.1.1.4
 - iii) NEW LATERAL CONNECTIONS TO BE PROVIDED PER R507.9.2
 - iv) ALL STAIRS AND RAILINGS TO COMPLY WITH REQUIREMENTS PER R311.7.1.9
- 5) INTERIOR FRAMING
 - a) ALL WINDOW AND DOOR OPENINGS TO BE RELOCATED AND RE-FRAMED PER DRAWINGS AND WINDOW SCHEDULE
 - b) INTERIOR WALLS TO BE LOCATED AND FRAMED AS SHOWN IN DRAWINGS WITH DOOR OPENINGS AS SHOWN
 - c) EXISTING WALLS (INTERIOR AND EXTERIOR) SHALL BE EVALUATED AND ANY BENT, WAIVED OR COMPROMISED STUDS TO BE REPLACED.
 - d) EXTERIOR WALL SHEATHING TO BE INSPECTED AND ANY DEFICIENCIES CORRECTED.
- 6) ROOF REPAIR
 - a) AFTER REMOVING TEMPORARY WATERPROOF COVERING AND OLD ROOFING MATERIALS
 - i) REPLACE ANY COMPROMISED RAFTERS
 - ii) REPLACE ANY ROTTED OR DELAMINATED ROOF SHEATHING
 - iii) INSTALL NEW FASCIA PER DRAWINGS
 - iv) INSTALL NEW UPON ROOFING MATERIAL
 - v) USE 1" CELOTEX UNDERLAYMENT AND ALL NAILING, ADHESIVE, TAPES AND EDGE TREATMENTS PER MANUFACTURER'S INSTRUCTIONS.
- 7) PLUMBING
 - a) ROUGH IN NEW PVC SANITARY DRAINAGE AND VENTS PER DRAWINGS
 - i) ALL ROOF PENETRATIONS TO BE PROPERLY FLASHED PER EPDM MANUFACTURER'S SPECIFICATIONS
 - b) ROUGH IN NEW PEX SUPPLY LINES TO ALL FIXTURES.
 - i) ALL PEX LINES TO BE 3/4" DIRECT TO ALL OUTLETS TERMINATING IN HOT AND COLD SUPPLY MANIFOLDS IN CRAWL SPACE.
 - ii) ALL SUPPLY LINES ARE TO BE PITCHED TO ALLOW SIMPLE GRAVITY DRAINAGE OF THE SUPPLY SYSTEM.
 - c) ELECTRICAL (ALL WORK TO COMPLY WITH NYP470-17 PER THE 2020 NEW YORK STATE UNIFORM FIRE PREVENTION AND BUILDING CODE, CHAPTER 50)
 - a) INSTALL NEW A NEW SERVICE ENTRANCE AND A NEW ELECTRICAL DISTRIBUTION PANEL WITH A MAIN SHUT-OFF BREAKER
 - b) ALL WIRING TO BE COPPER.
 - c) INSTALL DISTRIBUTION SYSTEM PER DRAWINGS AND CODE
 - d) PROVIDE ROUGH AND FINISHED ELECTRICAL INSPECTION CERTIFICATION BY AN AGENCY APPROVED BY THE SULLIVAN COUNTY ELECTRICAL LICENSING BOARD
 - e) ALL DEVICES AND FIXTURES TO BE UL APPROVED FOR INTENDED USE.

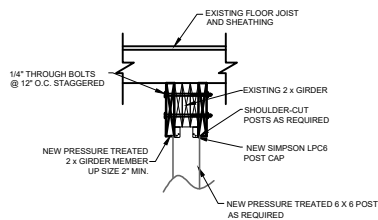


SECTION

GIRDER REINFORCEMENT DETAIL 1
SCALE: 1" = 1'-0"

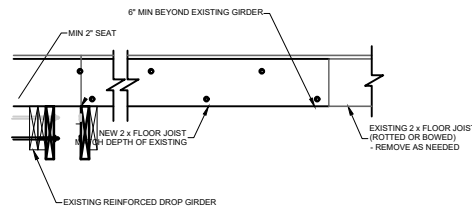


SIDE VIEW

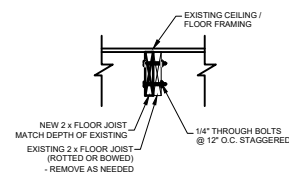


SECTION

FLOOR JOIST SISTERING DETAIL 2
SCALE: 1" = 1'-0"

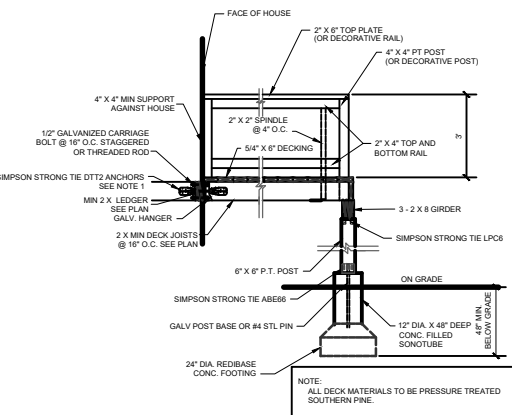


NOTE 1:
PER 2020 NYSRBC SECTION 507.9.2 DECK LATERAL LOAD CONNECTION. HOLD-DOWN TENSION DEVICE SHALL BE INSTALLED IN NOT LESS THAN TWO LOCATIONS PER DECK WITHIN 24-INCHES OF EACH END OF THE DECK. EACH DEVICE SHALL HAVE AN ALLOWABLE STRESS DESIGN CAPACITY OF NOT LESS THAN 1500 LBS.

DECK CONSTRUCTION DETAILS 3
SCALE: 1/2" = 1'-0"

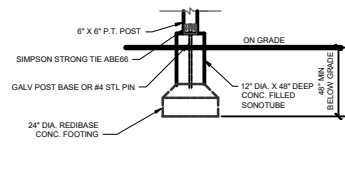

TYPICAL REPLACEMENT FOOTING DETAIL 4
SCALE: 1/2" = 1'-0"

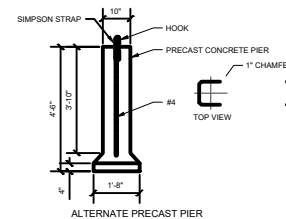

INTERIOR EXTERIOR
MAPPING AND SURVEYING
18 SPENCER BROOKLYN
NEW YORK 11211
(929) 486-9091
propicny.com
PROPICNY@GMAIL.COM

PROJECT NAME:
ARCHITECTURAL AS-BUILT
UNIT 39 - 42
631 OLD LIBERTY ROAD
TOWN OF THOMPSON, NY

ARCHITECT/ENGINEER

REVISIONS:		
NO.	DATE	MARK / DESCRIPTION

SHEET CONTENT:
SCOPE OF WORK
GIRDER REINFORCEMENT DETAIL
DECK CONSTRUCTION DETAILS
FLOOR JOIST SISTERING DETAILS
TYPICAL REPLACEMENT FOOTING DETAIL

DRAWN BY:	SHEET NO.:
	S-2
DATE:	
CHECKED:	
DATE:	
PROJECT NO.:	02