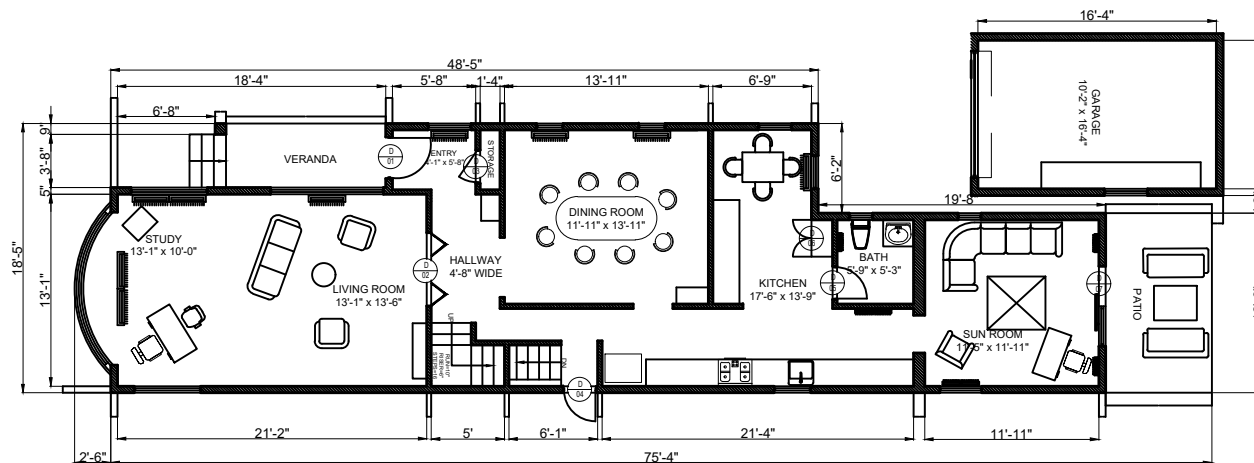


1
A-2 EXISTING BASEMENT PLAN
SCALE: 1/4"=1'



2
A-2 EXISTING FIRST FLOOR PLAN
SCALE: 1/4"=1'



PROPICNY
INTERIOR EXTERIOR SURVEYING AND AS-BUILT FLOOR PLANS

INTERIOR EXTERIOR
MAPPING AND SURVEYING
18 SPENCER BROOKLYN
NEW YORK 11211
(929) 486-9091
propicny.com
PROPICNY@GMAIL.COM

PROJECT NAME:
ARCHITECTURAL AS-BUILT

1558 E 26TH, NY

ARCHITECT/ENGINEER

REVISIONS:		
NO.	DATE	MARK / DESCRIPTION

SHEET CONTENT:
EXISTING BASEMENT PLAN
EXISTING FIRST FLOOR PLAN

DRAWN BY:		SHEET NO:	
DATE:			A-2
CHECKED:			
DATE:		OF:	

PROJECT NO: 05

INTERIOR EXTERIOR
MAPPING AND SURVEYING
18 SPENCER BROOKLYN
NEW YORK 11211
(929) 486-9091
propicny.com
PROPICNY@GMAIL.COM

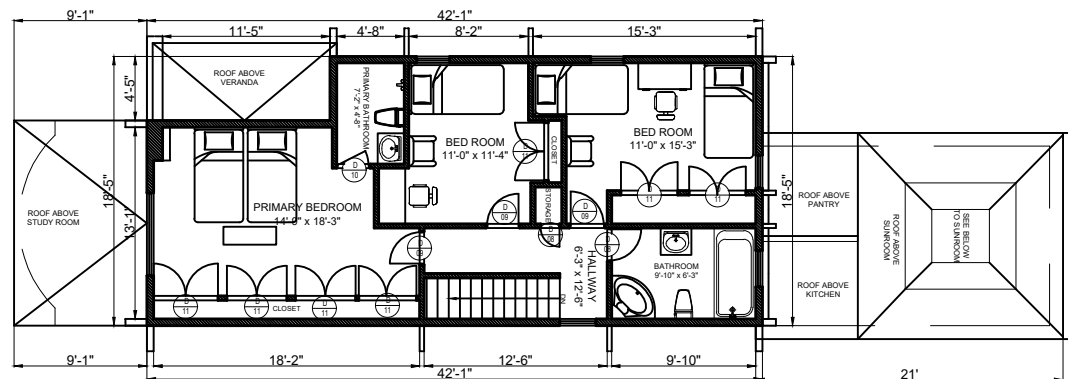
PROJECT NAME:
ARCHITECTURAL AS-BUILT
1558 E 26TH, NY

ARCHITECT/ENGINEER

REVISIONS:	
DATE	MARK / DESCRIPTION

SHEET CONTENT:
EXISTING SECOND FLOOR PLAN

DRAWN BY:		SHEET NO:	
CHECKED:			A-3
		OF:	
PROJECT NO:			05



1
A-3 EXISTING SECOND FLOOR PLAN
SCALE: 1/4"=1'

INTERIOR EXTERIOR
MAPPING AND SURVEYING
18 SPENCER BROOKLYN
NEW YORK 11211
(929) 486-9091
propicny.com
PROPICNY@GMAIL.COM








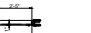

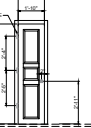
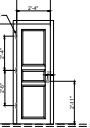
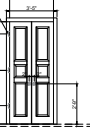
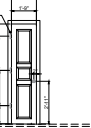
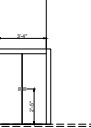
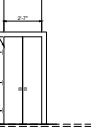
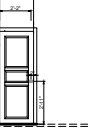
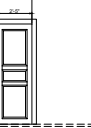

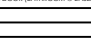
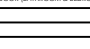
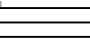
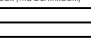
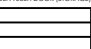
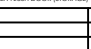
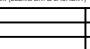
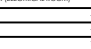
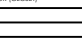
PROJECT NAME:
ARCHITECTURAL AS-BUILT
1558 E 26TH, NY

ARCHITECT/ENGINEER



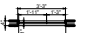
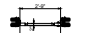

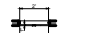

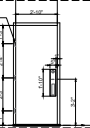
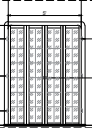
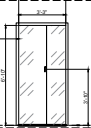
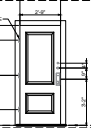
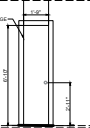
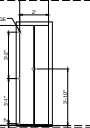

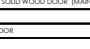
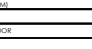
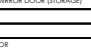
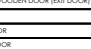



REVISIONS:	
DATE	MARK / DESCRIPTION

SHEET CONTENT:
EXISTING DOOR SCHEDULE @
BASEMENT
EXISTING DOOR SCHEDULE @
FIRST FLOOR

DRAWN BY:		SHEET NO:	
CHECKED:		OF:	A-4
PROJECT NO:			05

	D12	D13	D14	D15	D16	D17	D18	D19	
OPENING PLAN									
SHAPE / SIZE									
FLOOR FINISH LEVEL STRUCTURE LEVEL									
SPECIFICATION	WOODEN PANEL DOOR (BATHROOM @ BASEMENT)	WOODEN PANEL DOOR (BATHROOM & BEDROOM)	DOUBLE LEAF WOODEN PANEL DOOR (CLOSET (DRESSING))	WOODEN PANEL DOOR (WIC & BATHROOM)	DOUBLE LEAF WOODEN FLUSH DOOR (STORAGE)	DOUBLE LEAF WOODEN FLUSH DOOR (STORAGE)	WOODEN PANEL DOOR (BEDROOM & LAUNDRY)	WOODEN FLUSH DOOR (ELECTRICAL ROOM)	WOODEN POCKET DOOR (CLOSET)
LOCATION	FIRST FLOOR SECOND FLOOR BASEMENT TOTAL	FIRST FLOOR SECOND FLOOR BASEMENT TOTAL	FIRST FLOOR SECOND FLOOR BASEMENT TOTAL	FIRST FLOOR SECOND FLOOR BASEMENT TOTAL	FIRST FLOOR SECOND FLOOR BASEMENT TOTAL	FIRST FLOOR SECOND FLOOR BASEMENT TOTAL	FIRST FLOOR SECOND FLOOR BASEMENT TOTAL	FIRST FLOOR SECOND FLOOR BASEMENT TOTAL	FIRST FLOOR SECOND FLOOR BASEMENT TOTAL

1
A-4
EXISTING DOOR SCHEDULE @ BASEMENT
SCALE: 1/4"=1'

	D1	D2	D3	D4	D5	D6	D7
OPENING PLAN							
SHAPE / SIZE							
FLOOR FINISH LEVEL STRUCTURE LEVEL							
SPECIFICATION	SINGLE LEAF SOLID WOOD DOOR (MAIN DOOR)	DOUBLE FOLDING WOODEN FRAMED GLASS DOOR (LIVING ROOM)	SINGLE LEAF WOODEN DOOR (STORAGE)	SINGLE LEAF WOODEN DOOR (EXIT DOOR)	WOODEN FLUSH DOOR (BATHROOM)	WOODEN FLUSH DOOR (PANTRY)	SLIDING GLASS DOOR (ENTERTAINMENT ROOM)
LOCATION	FIRST FLOOR SECOND FLOOR BASEMENT TOTAL	FIRST FLOOR SECOND FLOOR BASEMENT TOTAL	FIRST FLOOR SECOND FLOOR BASEMENT TOTAL	FIRST FLOOR SECOND FLOOR BASEMENT TOTAL	FIRST FLOOR SECOND FLOOR BASEMENT TOTAL	FIRST FLOOR SECOND FLOOR BASEMENT TOTAL	FIRST FLOOR SECOND FLOOR BASEMENT TOTAL

2
A-4
EXISTING DOOR SCHEDULE @ FIRST FLOOR PLAN
SCALE: 1/4"=1'

INTERIOR EXTERIOR
MAPPING AND SURVEYING
18 SPENCER BROOKLYN
NEW YORK 11211
(929) 486-9091
propicny.com
PROPICNY@GMAIL.COM

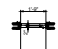
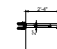


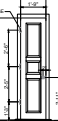



PROJECT NAME:
ARCHITECTURAL AS-BUILT
1558 E 26TH, NY

ARCHITECT/ENGINEER

REVISIONS:	
DATE	MARK / DESCRIPTION

SHEET CONTENT:
EXISTING DOOR SCHEDULE @
SECOND FLOOR

DRAWN BY:		SHEET NO:	
CHECKED:			A-5
		OF:	
PROJECT NO:			05

D8	D9	D10	D11
			
<div>1 A-5</div> EXISTING RIGHT - SIDE ELEVATION SCALE: 1/4"=1'			
			
WOODEN PANEL DOOR (BATHROOM)	WOODEN PANEL DOOR (MASTERS & BEDROOMS / H.Q.)	WOODEN PANEL DOOR (MASTERS BATHROOM)	DOUBLE LEAF WOODEN PANEL DOOR (CLOSET)
FIRST FLOOR	FIRST FLOOR	FIRST FLOOR	FIRST FLOOR
SECOND FLOOR	SECOND FLOOR	SECOND FLOOR	SECOND FLOOR
BASEMENT	BASEMENT	BASEMENT	BASEMENT
TOTAL	TOTAL	TOTAL	TOTAL

1
A-5

EXISTING DOOR SCHEDULE @ SECOND FLOOR
SCALE: 1/4"=1'