


1
A-2
EXISTING BASEMENT PLAN
SCALE: 1/4"=1'



2
A-2
EXISTING FIRST FLOOR PLAN
SCALE: 1/4"=1'

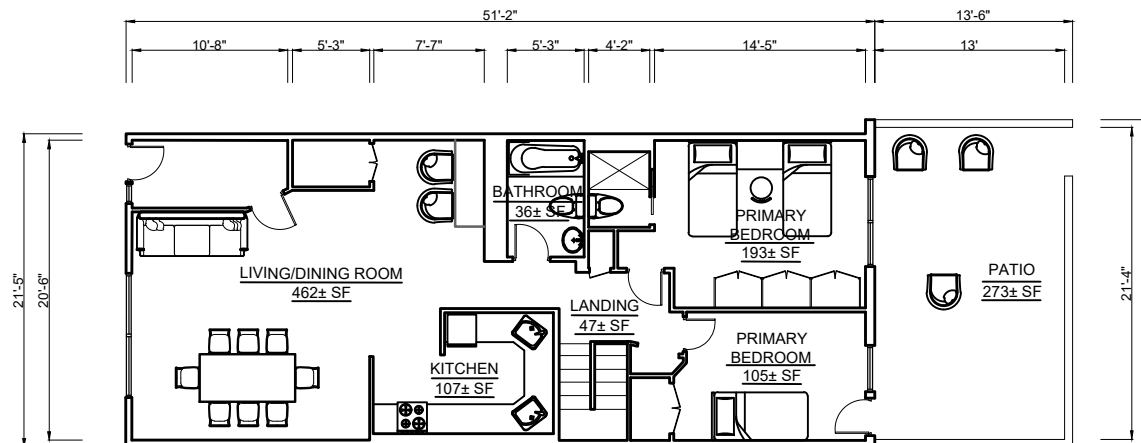

PROPICNY

INTERIOR EXTERIOR SURVEYING AND AS-BUILT FLOOR PLANS

INTERIOR EXTERIOR
MAPPING AND SURVEYING
18 SPENCER BROOKLYN
NEW YORK 11211
(929) 486-9091
propicny.com
PROPICNY@GMAIL.COM

PROJECT NAME:
ARCHITECTURAL AS-BUILT

695 E SECOND STREET

ARCHITECT/ENGINEER

REVISIONS:		
NO.	DATE	MARK / DESCRIPTION

SHEET CONTENT:
EXISTING BASEMENT PLAN
EXISTING FIRST FLOOR PLAN

DRAWN BY:		SHEET NO:	
DATE:			A-2
CHECKED:			
DATE:		OF:	
PROJECT NO:			05

INTERIOR EXTERIOR
MAPPING AND SURVEYING
18 SPENCER BROOKLYN
NEW YORK 11211
(929) 486-9091
propicny.com
PROPICNY@GMAIL.COM


PROJECT NAME:
ARCHITECTURAL AS-BUILT
695 E SECOND STREET

ARCHITECT/ENGINEER


REVISIONS:	
DATE	MARK / DESCRIPTION

SHEET CONTENT:
EXISTING FRONT ELEVATION
EXISTING LEFT - SIDE ELEVATION


DRAWN BY:		SHEET NO.:	
CHECKED:		OF:	A-3
PROJECT NO.:			05

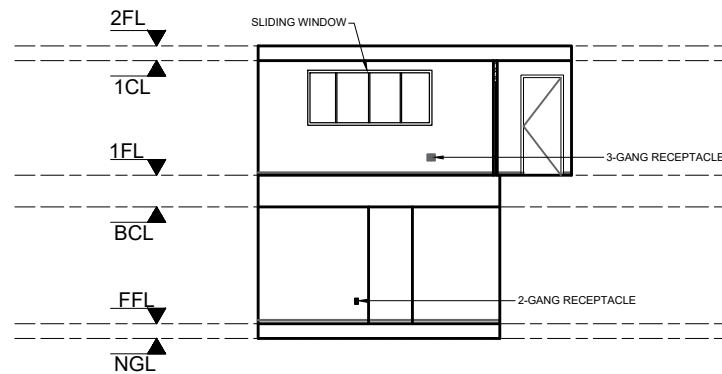


1 EXISTING FRONT ELEVATION
SCALE: 1/4"=1'

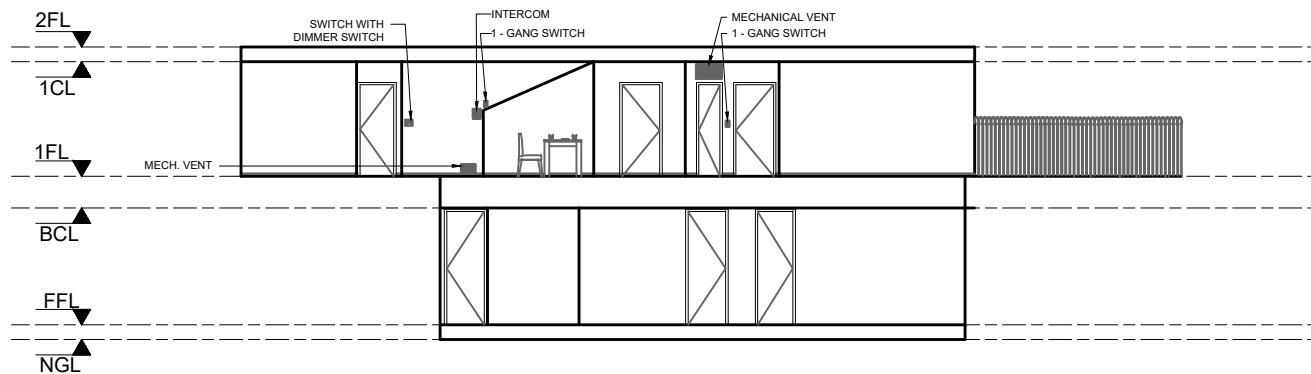

2 EXISTING LEFT - SIDE ELEVATION
SCALE: 1/4"=1'

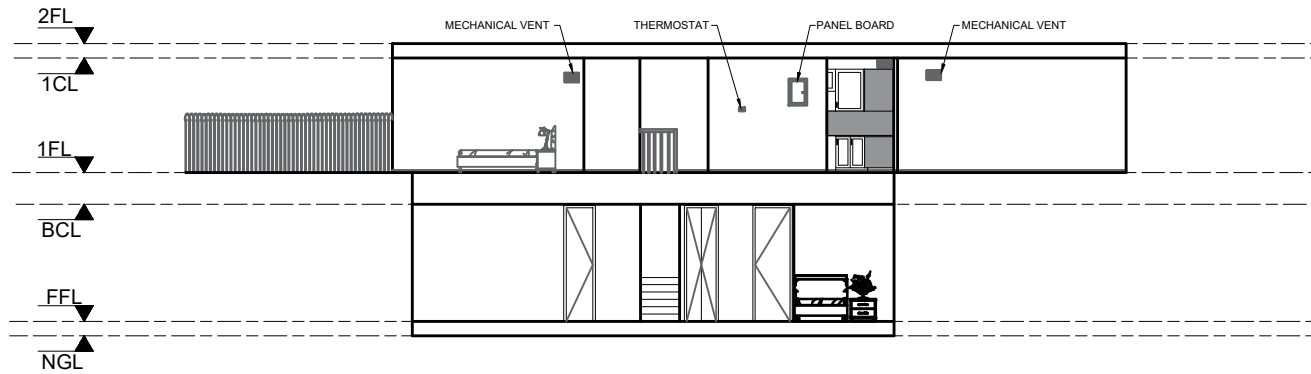

1
A-4
EXISTING RIGHT - SIDE ELEVATION
SCALE: 1/4"=1'-0"

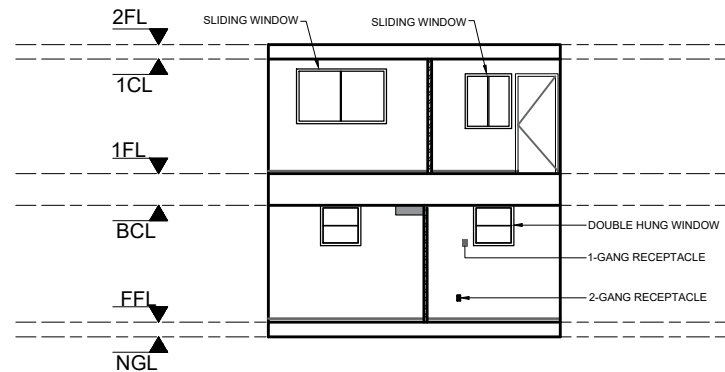

2
A-4
EXISTING REAR ELEVATION
SCALE: 1/4"=1'-0"



PROPICNY

INTERIOR EXTERIOR SURVEYING AND AS-BUILT FLOOR PLANS

INTERIOR EXTERIOR
MAPPING AND SURVEYING
18 SPENCER BROOKLYN
NEW YORK 11211
(929) 486-9091
propicny.com
PROPICNY@GMAIL.COM

PROJECT NAME:

ARCHITECTURAL AS-BUILT


695 E SECOND STREET

ARCHITECT/ENGINEER


REVISIONS:	
DATE	MARK / DESCRIPTION

SHEET CONTENT:
EXISTING RIGHT - SIDE ELEVATION
EXISTING REAR ELEVATION

DRAWN BY:		SHEET NO.:	
CHECKED:			A-4
PROJECT NO.:		OF:	
			05

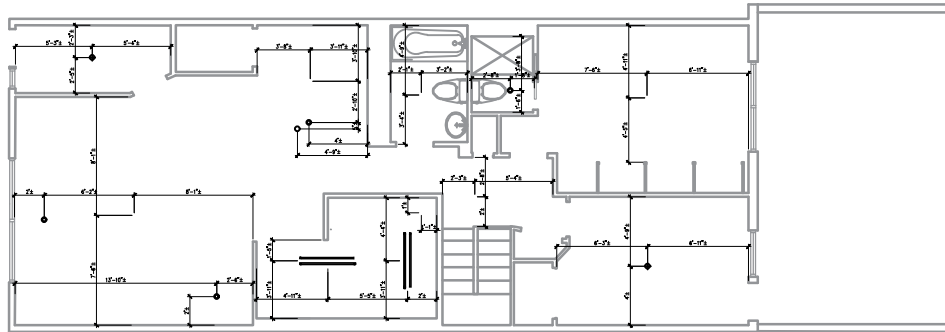

1
A-5
EXISTING REFLECTED CEILING PLAN @ 1ST FLOOR
SCALE: 1/4"=1'-0"

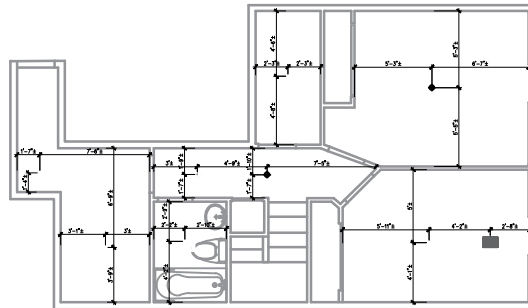

2
A-5
EXISTING REFLECTED CEILING PLAN @ BASEMENT
SCALE: 1/4"=1'-0"

REFLECTED CEILING PLAN LEGEND	
SYMBOL	
	CEILING MECHANICAL VENT
	CEILING MOUNTED LIGHT FIXTURE
	RECESSED LIGHT FIXTURE
	RECESSED BLANK PLATE
	DOME LIGHT FIXTURE
	RECESSED SQUARE LIGHT FIXTURE
	DOUBLE LED TUBE LIGHT FIXTURE
	SINGLE LED TUBE LIGHT FIXTURE
	CEILING MOUNTED SIGNAL BOOST
	ROUGHING IN FOR CEILING MECHANICAL VENT

RCP PLAN GENERAL NOTES

1. THE CONTRACTOR SHALL COMPARE THIS REFLECTED CEILING PLAN WITH ELECTRICAL LIGHTING PLANS, MECHANICAL SUPPLY, RETURN, AND EXHAUST PLANS. THE CONTRACTOR SHALL REPORT ANY OMISSIONS OR INCONSISTENCIES TO THE ARCHITECT.
2. SEE ELECTRICAL DRAWINGS FOR THE LOCATIONS OF CEILING MOUNTED SMOKE DETECTORS, SPEAKERS, EXIT SIGNAGE, AND FIRE ALARM DEVICES, ETC. ALSO SEE ELECTRICAL FOR LOCATIONS OF WALL MOUNTED EXIT LIGHTS.
3. FOR FURTHER DIMENSIONS SEE LARGE SCALE PLANS, SECTIONS, ELEVATIONS, AND DETAILS.
4. THE CONTRACTOR SHALL VERIFY THAT ACCESS PANELS OF TYPE SPECIFIED ARE INSTALLED IN NONACCESSIBLE TYPE CEILINGS WHERE SERVICE OR ADJUSTMENT TO MECHANICAL, PLUMBING, OR ELECTRICAL ITEMS MAY BE REQUIRED. ACCESS PANELS SHALL BE EQUAL TO THE RATING OF THE WALL OR CEILING IN WHICH THEY OCCUR.
5. ALL CEILING ELEMENTS TO BE PLACED IN THE CENTER OF CEILING TILE OR CENTER OF GYP. BOARD CEILING AREA U.N.O.
6. ALL CEILING GRIDS TO BE CENTERED BETWEEN WALLS U.N.O.
7. PAINT ALL ELEMENTS AND STRUCTURE EXPOSED ABOVE CEILING IN OCCUPIED SPACES, INCLUDING STORAGE ROOMS, WORKSHOP AND NEW SERVER ROOM. DO NOT PAINT EXISTING TELE DATA ROOM.
8. CONTRACTOR SHALL PAINT ALL ITEMS ABOVE THE CEILING AT ANY PARTICULAR LOCATION WHERE ANY ITEMS ABOVE CEILING ARE EXPOSED, SUCH AS PERIMETER CEILING CONDITIONS.



INTERIOR EXTERIOR
MAPPING AND SURVEYING
18 SPENCER BROOKLYN
NEW YORK 11211
(929) 486-9091
propicny.com
PROPICNY@GMAIL.COM

PROJECT NAME:
**ARCHITECTURAL AS-BUILT
695 E SECOND STREET**

ARCHITECT/ENGINEER

REVISIONS:	
DATE	MARK / DESCRIPTION

SHEET CONTENT:	
EXISTING REFLECTED CEILING PLAN @ BASEMENT	
EXISTING REFLECTED CEILING PLAN @ 1ST FLOOR	
RCP GENERAL NOTES	
RCP LEGENDS	

DRAWN BY:	SHEET NO:
	A-5
CHECKED:	OF:
PROJECT NO:	05